


LOCUS MAP / 1" = 1000'

I HEREBY CERTIFY TO THE TOWN OF WAREHAM BUILDING COMMISSIONER THAT THE FOUNDATION SHOWN IS THE RESULT OF AN INSTRUMENT SURVEY CONDUCTED BY G.A.F. ENGINEERING, INC.



RAB 9/27/2021

ROBERT A. BRAMAN, JR., PLS#45850

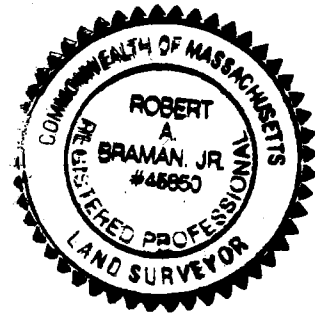

GRAPHIC SCALE

SCALE 1" = 20'

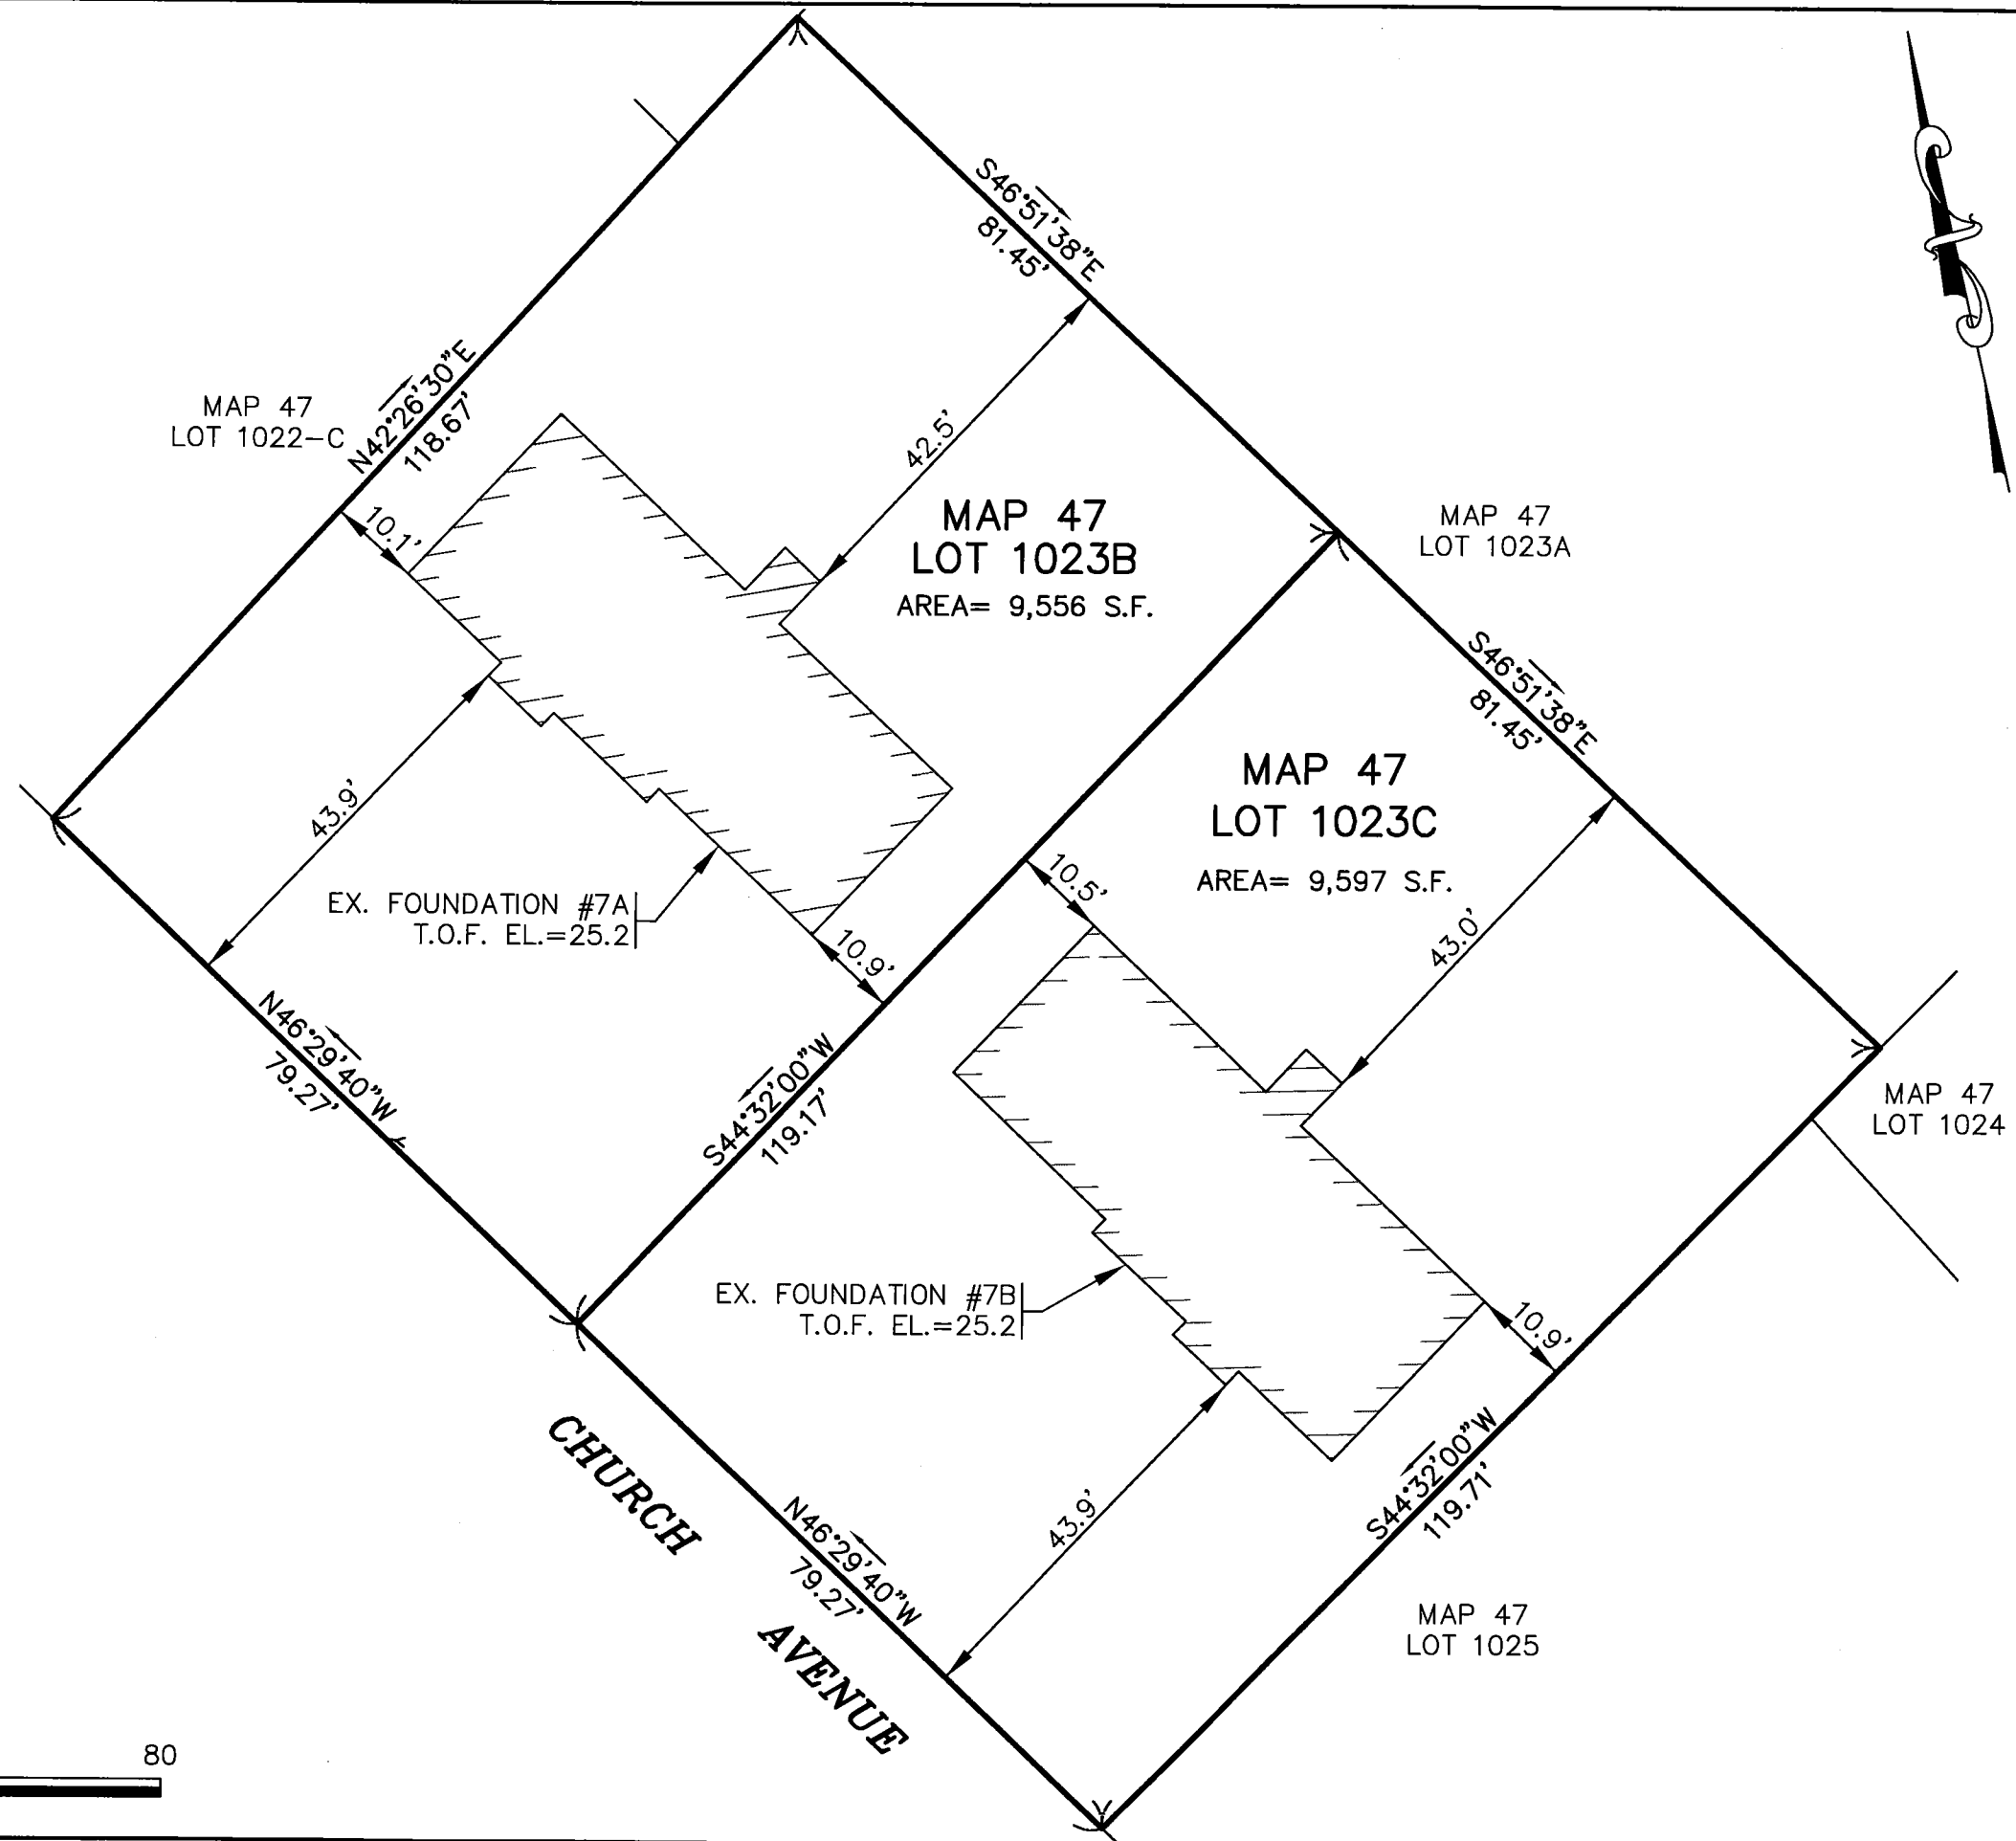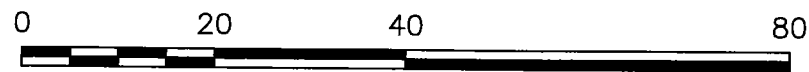

G.A.F. ENGINEERING, INC. PROFESSIONAL ENGINEERS & LAND SURVEYORS 266 MAIN STREET - WAREHAM, MA 02571 TEL: (508) 295-6600 FAX: (508) 295-6634 E-MAIL: info@gafenginc.com		REV. DATE BY APP'D DESCRIPTION
AS-BUILT FOUNDATION PLAN 7A & 7B CHURCH AVENUE WAREHAM, MA. PREPARED FOR: 108 HIGH STREET REALTY TRUST P.O. BOX 882 W. WAREHAM, MA		DATE: SEPT. 27, 2021 DRAWN BY: JMP CHECKED BY: RAB
DWG. 1 OF 1		JOB NO.: 21-9684 SCALE: 1" = 40'