

ADDENDUM NO. 4



TO

CONTRACT DOCUMENTS

**IMPROVEMENTS TO BAYVIEW PARK, HIGHLAND AVENUE SIDEWALK
IMPROVEMENTS, AND IMPROVEMENTS TO THE LILLIAN GREGERMAN BANDSHELL
WAREHAM, MA**

Bid #1048

February 6, 2024

NOTICE TO BIDDERS

The attention of all bidders submitting proposals for “Improvements to Bayview Park, Highland Avenue Sidewalk Improvements, and Improvements to the Lillian Gregerman Bandshell” is called to the following Addenda to the specifications and plans. The items set forth herein, whether of omission, addition or substitution are to be included in, and form part of the specifications and plans of the above-named project for bids to be received as advertised.

**PLEASE BE SURE TO ACKNOWLEDGE
THIS ADDENDUM ON BID PRICING PAGE**

The following clarifications, modifications, deletions, and additions are hereby incorporated into and become part of the Contract Documents.

WRITTEN CHANGES AND CLARIFICATIONS TO DRAWINGS

1. **DELETE:** Sheet L506

REPLACE: Sheet L506, per attachment

2. **DELETE:** The limits of the revision cloud on Sheet L130, as shown in SK-6 per attachment

REPLACE: SK-6 per attachment

3. **FOR CLARIFICATION:** It shall be noted that SK-4 per Addendum 3 shall be considered a similar replacement for Detail C, Sheet L-1.3 on the Lillian Gregerman Bandshell. Layout on Sheet CM101 and grading on Sheet CG101 of the ramp and surroundings shall accommodate revisions included in SK-4 per Addendum 3.

QUESTIONS AND CLARIFICATIONS


Question 1: Please provide detail for the proposed reinforcement within the concrete footings for the Gazebo wood ramp system at Bayview Park.

Answer: Reinforcement is included L506, per attachment.

ATTACHMENTS:

L506
SK-6: REVISIONS TO THE ADA RAMP LAYOUT

END OF ADDENDUM NO. 4

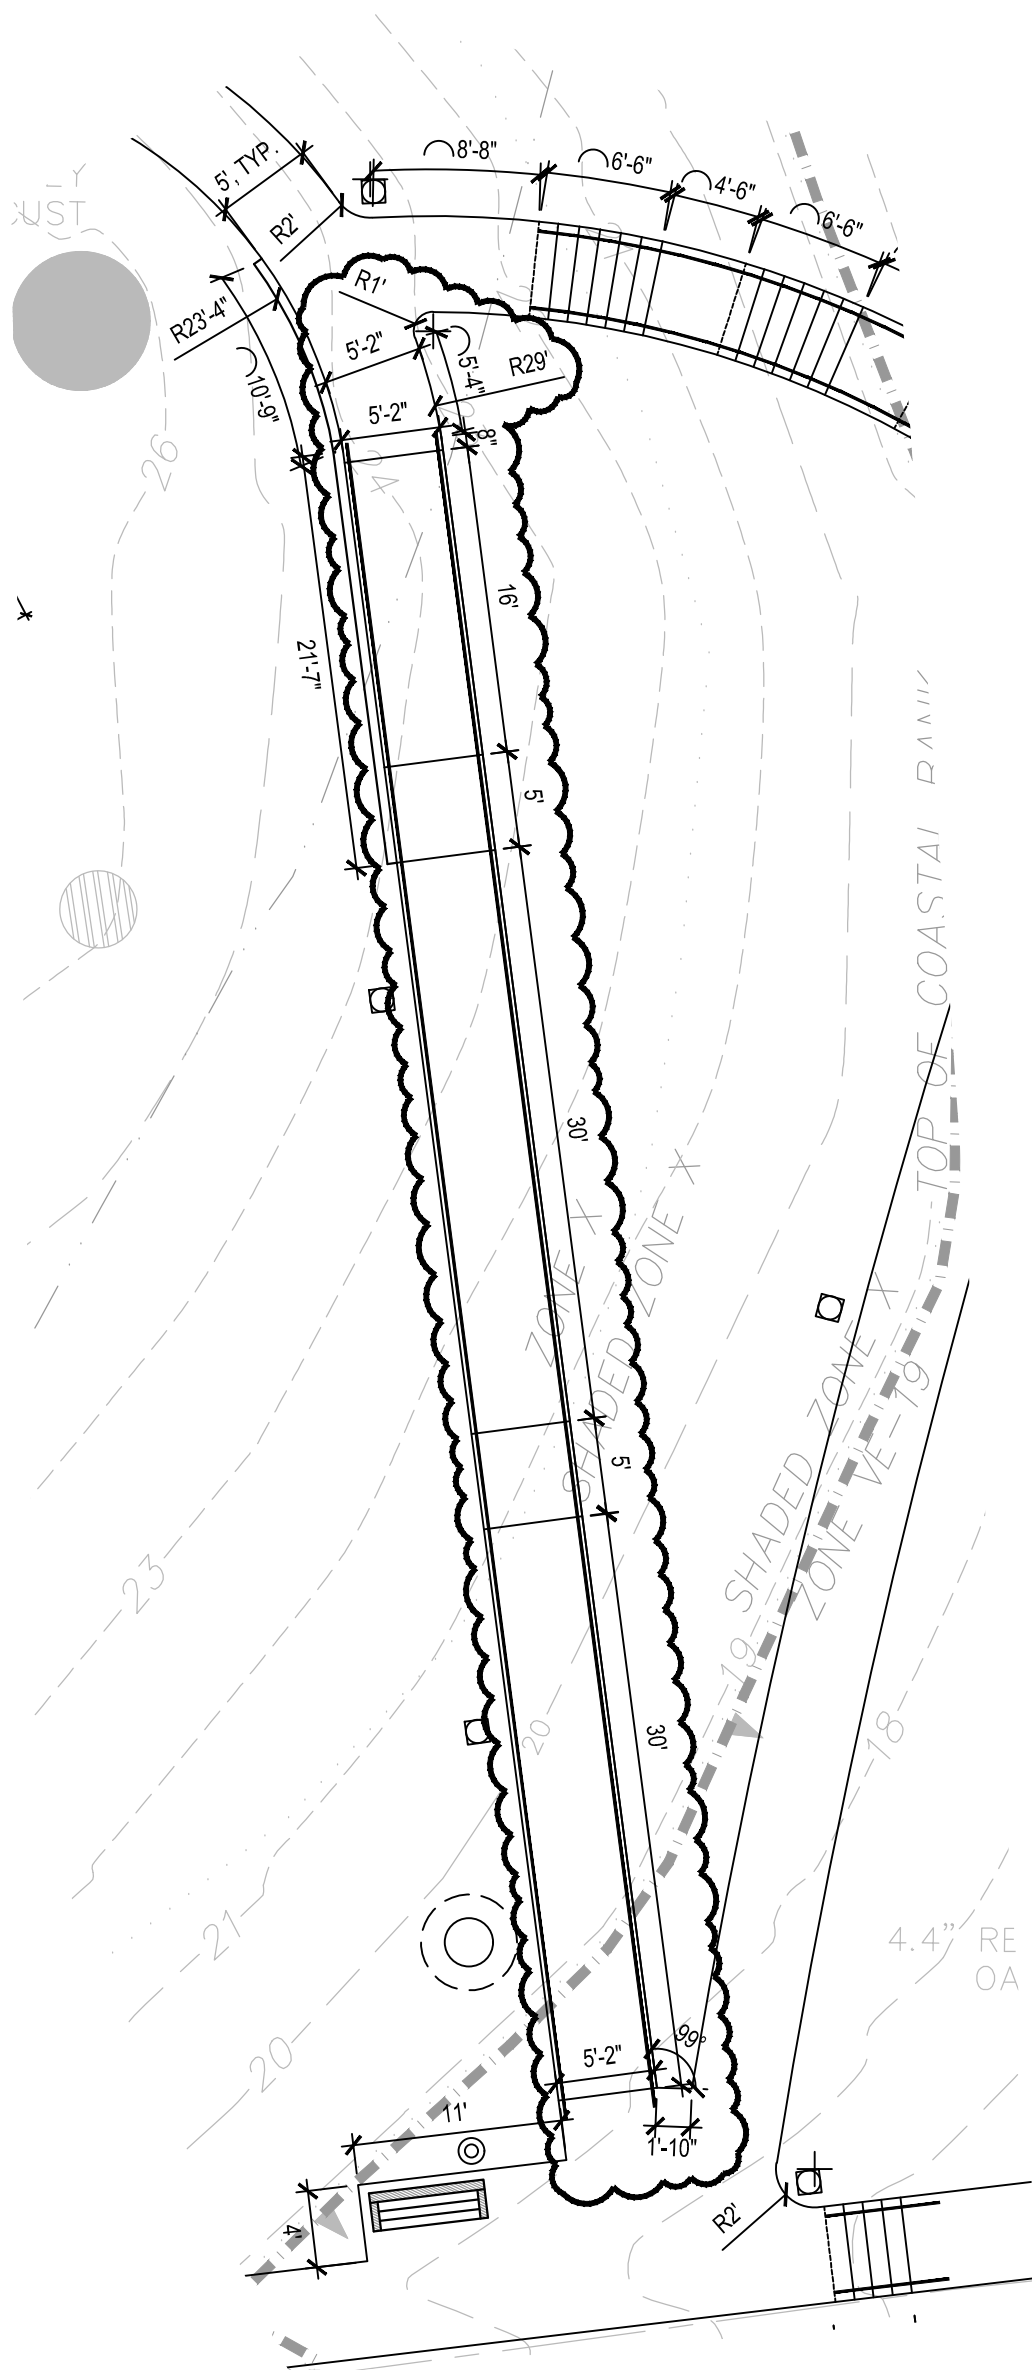

Weston & Sampson

85 Devonshire Street,
3rd Floor, Boston, MA 02109
617.412.4480 800.SAMPSON
www.westonandsampson.com

IMPROVEMENTS TO BAYVIEW PARK

REVISIONS TO THE ADA RAMP LAYOUT

Drawn by: TZ Reviewed by: CB

Date: 02/05/2024

Scale: 1"=10'-0"

SK-6

Consultants:

Revisions:

No.	Date	Description
7	02/06/2024	REVISION TO THE CONSTRUCTION DETAILS

Seal:

Issued For:

BID DOCUMENTS

Scale: AS NOTED

Date: NOVEMBER 30, 2023

Drawn By: TZ

Reviewed By: CB

Approved By: BK

W&S Project No: ENG21-1048

W&S File No:

Drawing Title:

**CONSTRUCTION
DETAILS**

Sheet Number:

L506

COPYRIGHT 2022 WESTON & SAMPSON

