

Revisions			
No.	Description	Date	App'd.

1 REVISE PER FEED REVIEW COMMENTS 2/2/22 KJM  
Date 10/7/2021

Scale 1"=40'

Drawn By RMS Designed By KJM Checked By RRR

Issued For **PERMITTING**




**DEFINITIVE SUBDIVISION PLAN OF LAND**  
**SHELL POINT PLACE**  
**DAVID ANDRADE**  
68 GREAT NECK ROAD  
WAREHAM, MASSACHUSETTS

Drawing Title  
**GRADING AND DRAINAGE**

Project No. 2443 Sheet 5 OF 8

Sheet No. **GD-1**

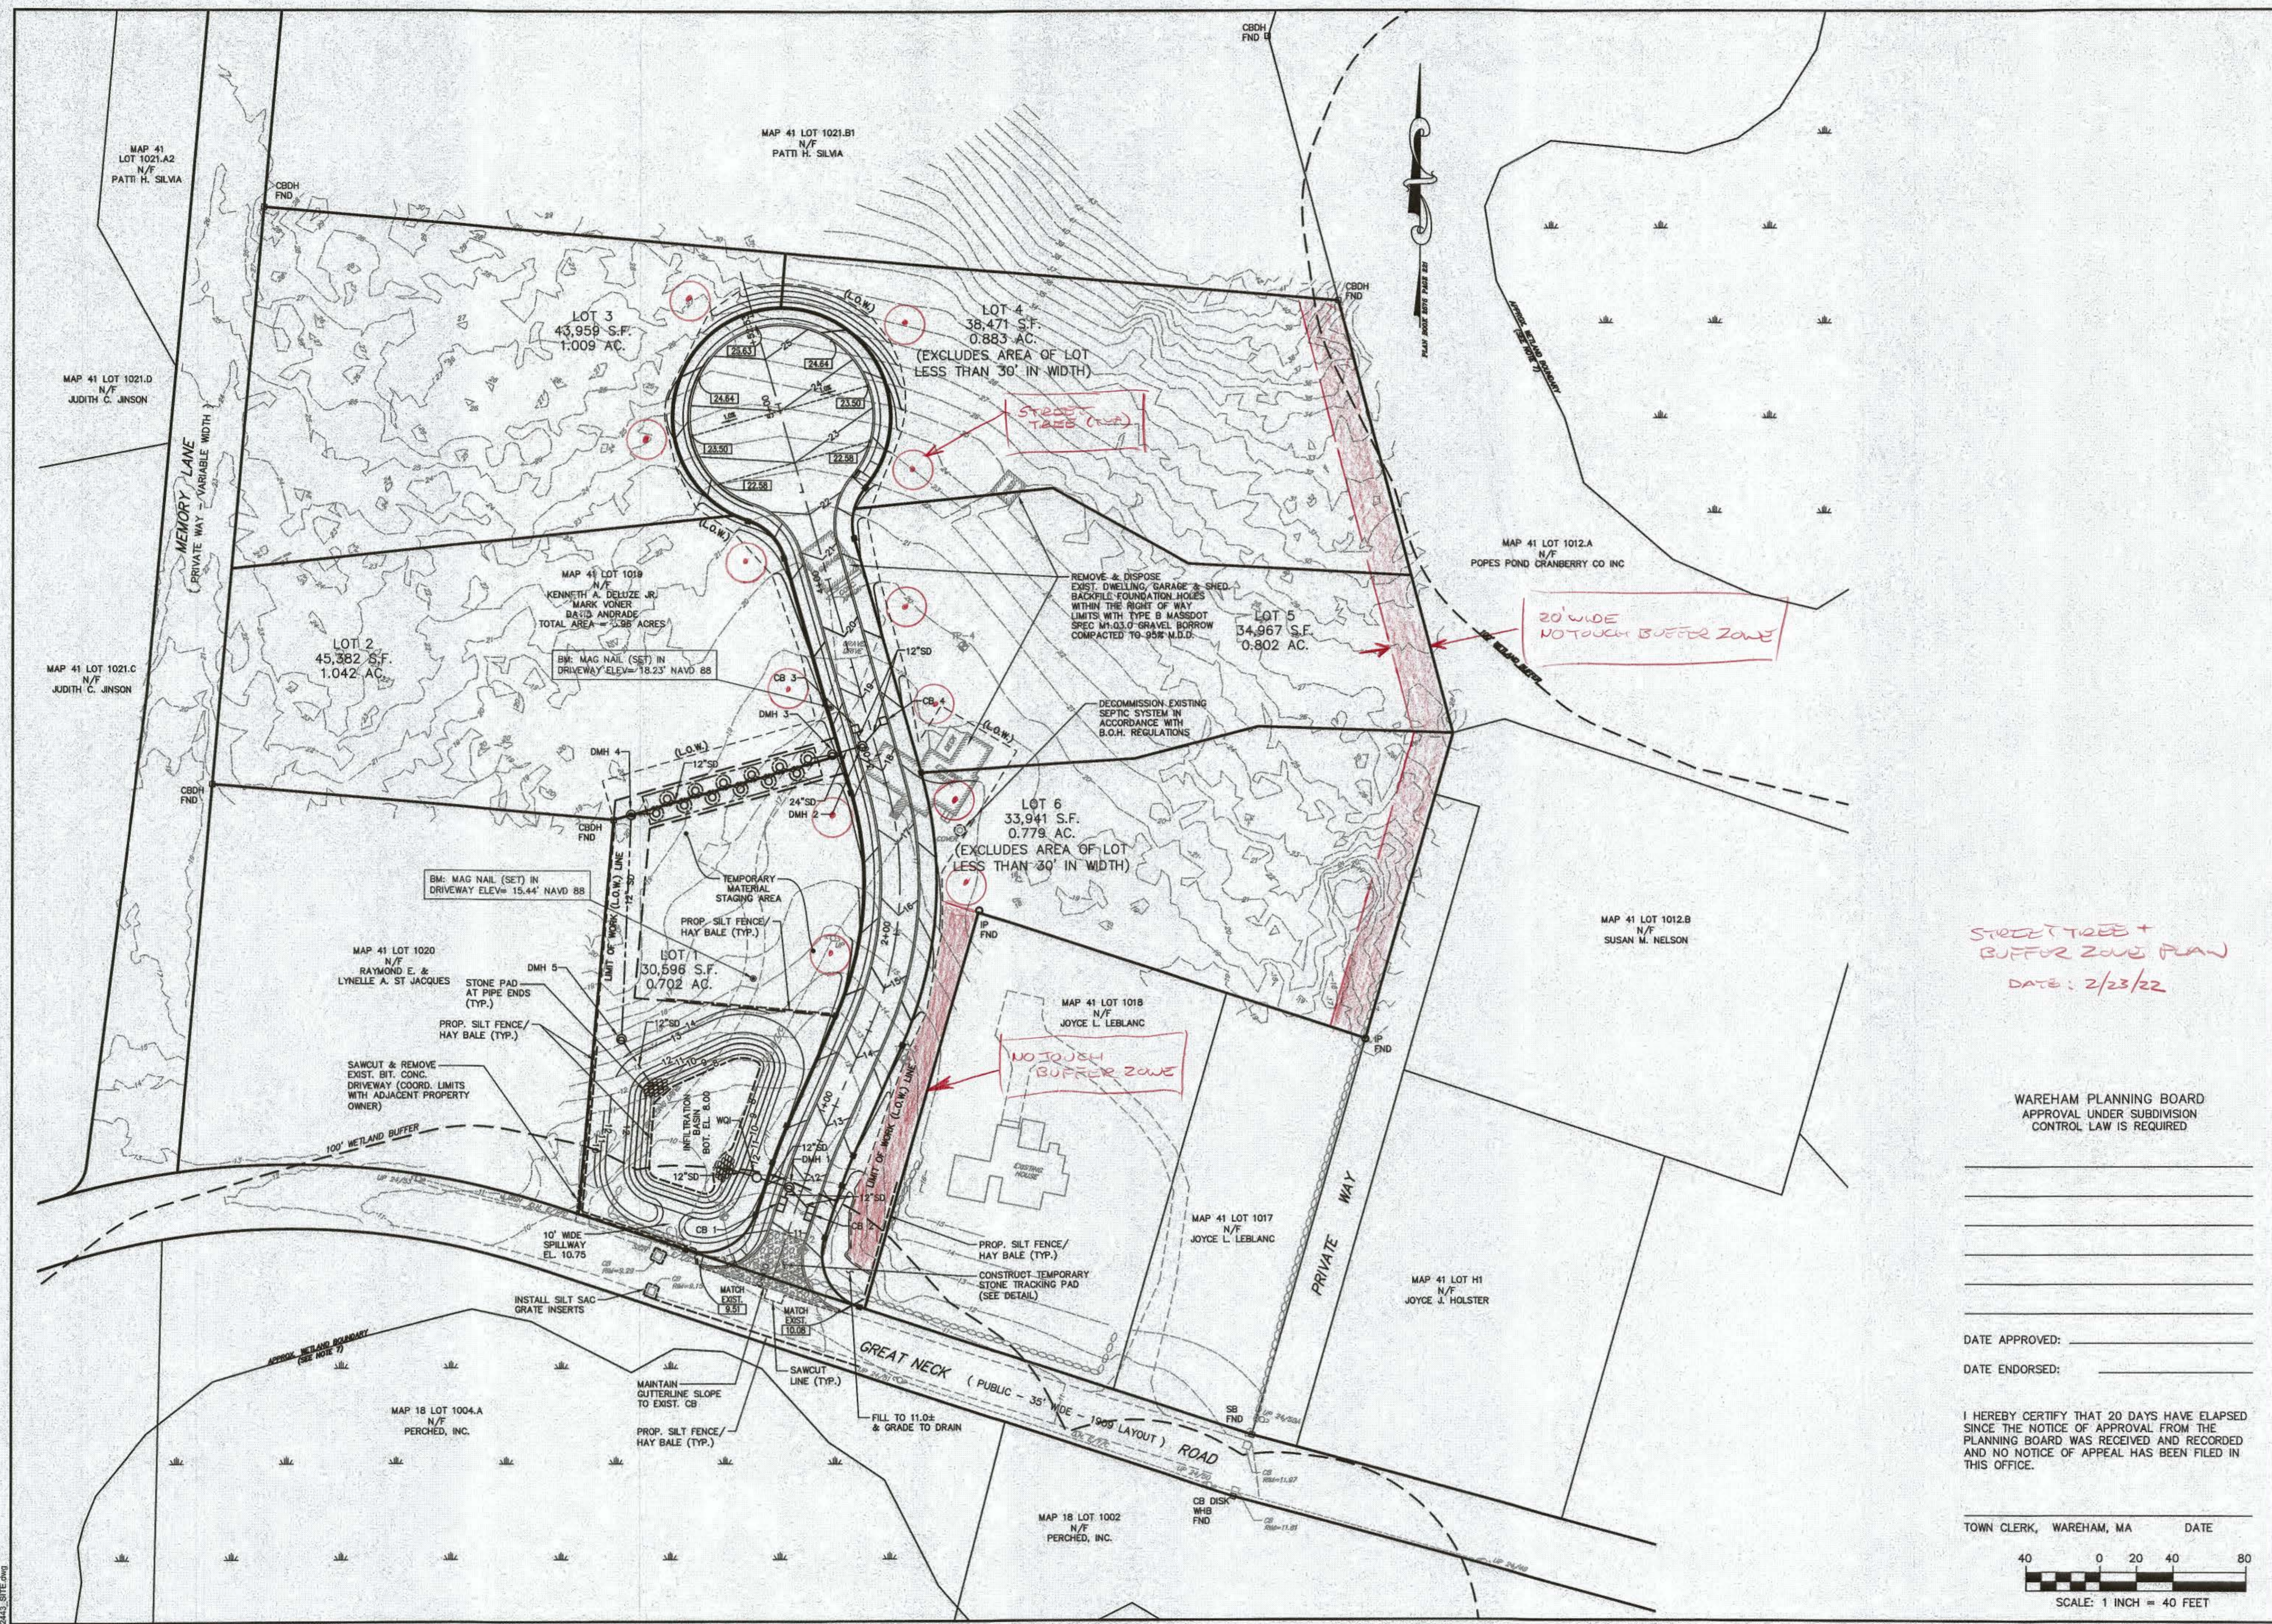

STREET TREES +  
BUFFER ZONE PLAN  
DATE: 2/23/22

WAREHAM PLANNING BOARD  
APPROVAL UNDER SUBDIVISION  
CONTROL LAW IS REQUIRED

DATE APPROVED: \_\_\_\_\_  
DATE ENDORSED: \_\_\_\_\_

I HEREBY CERTIFY THAT 20 DAYS HAVE ELAPSED  
SINCE THE NOTICE OF APPROVAL FROM THE  
PLANNING BOARD WAS RECEIVED AND RECORDED  
AND NO NOTICE OF APPEAL HAS BEEN FILED IN  
THIS OFFICE.

TOWN CLERK, WAREHAM, MA DATE

